


1	2	3	4	5	6	7	8	9	10	11	12
(R)	(R)	(R)	(R)	(R)	(R)	(R)	(R)	(WK)	(WK)	(WK)	(WK)
(Y)	(Y)	(Y)	(Y)	(Y)	(Y)	(Y)	(Y)	(DW)	(DW)	(DW)	(DW)
(G)	(G)	(G)	(G)	(G)	(G)	(G)	(G)				
(4G)							(Y)				

PHASE A	G	G	G	G	R	R	R	R	DW	DW	FL/WK	FL/WK	OUT
A YELLOW	G	G	Y	Y	R	R	R	R	DW	DW	FL/DW	FL/DW	OUT
PHASE B	G	G	R	R	R	R	R	R	DW	DW	DW	DW	OUT
B YELLOW	Y/G	Y/G	R	R	R	R	R	R	DW	DW	DW	DW	OUT
PHASE C	R	R	R	R	G	G	G	G	DW	DW	DW	DW	OUT
C YELLOW	R	R	R	R	Y	Y	Y	Y	DW	DW	DW	DW	OUT
PHASE C ALT	R	R	R	R	G	G	G	G	FL/WK	FL/WK	DW	DW	OUT
PED CLEARANCE	R	R	R	R	G	G	G	G	FL/DW	FL/DW	DW	DW	OUT
C ALT YELLOW	R	R	R	R	Y	Y	Y	Y	FL/DW	FL/DW	DW	DW	OUT
FLASHING													
OPERATION	FL/Y	FL/Y	FL/Y	FL/Y	FL/R	FL/R	FL/R	FL/R	OUT	OUT	OUT	OUT	

NOTE: IF "PHASE A" COMES UP IMMEDIATELY AFTER "PHASE B", SIGNAL # 8 IN "B YELLOW" WILL DISPLAY ; BUT IF "PHASE C" OR "PHASE C ALT" COMES UP IMMEDIATELY AFTER "PHASE B" SIGNAL # 8 WILL BECOME SOLID GREEN

NOTE: IF "PHASE A" COMES UP IMMEDIATELY AFTER "PHASE B", SIGNALS NO. 1 & 2 WILL DISPLAY A BALL GREEN IN "B PHASE" YELLOW

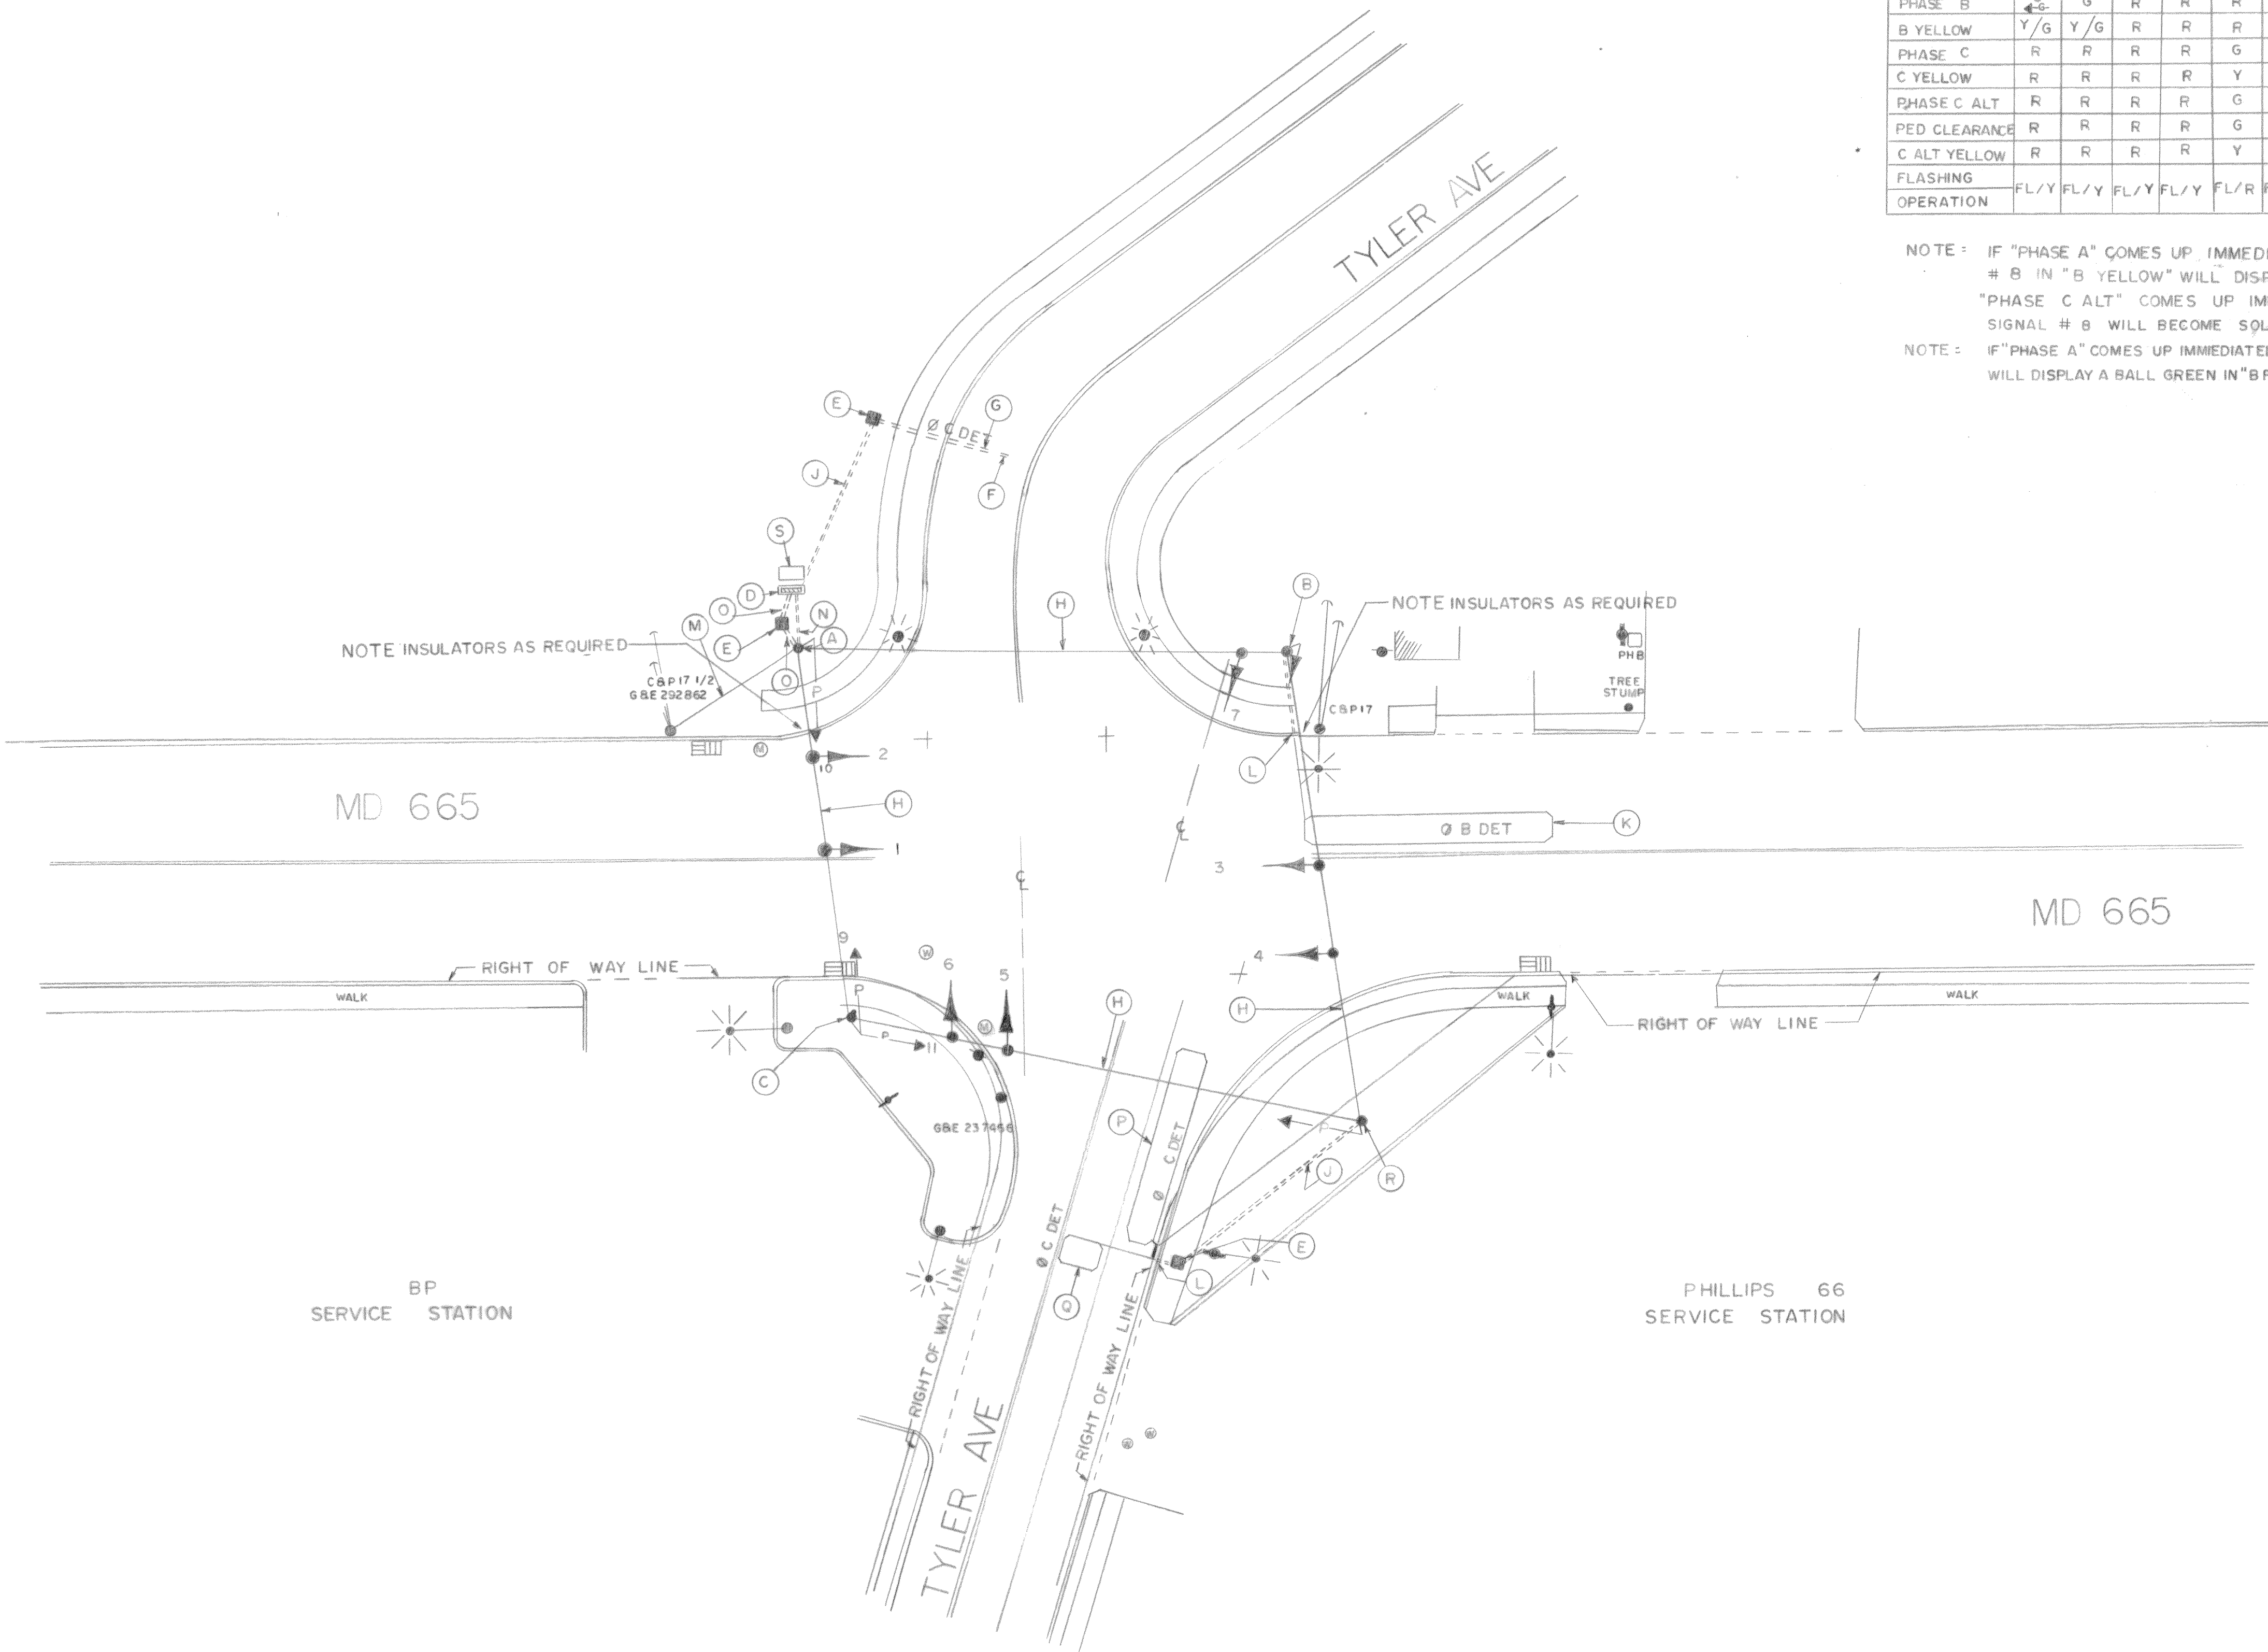

APPROVAL: CHIEF SIGNAL DESIGN SECTION	
APPROVAL: LAWRENCE E ELLIOT 1/31/72 REGIONAL TRAFFIC ENGINEER	
APPROVAL: CHIEF-BUREAU OF TRAFFIC ENGINEERING	B 7/13/83 RE-DRAWN
APPROVAL: THOMAS HICKS 2/2/72 ASST. CHIEF ENGINEER TRAFFIC	A 7/25/73 AS BUILT
	PM DD HR WF
	REVISIONS

STATE OF MARYLAND
DEPARTMENT OF TRANSPORTATION
STATE HIGHWAY ADMINISTRATION
TRAFFIC DIVISION - BUREAU OF TRAFFIC ENGINEERING
(Forest Dr.)
MD 665 & TYLER AVE

SCALE 1"=20' DATE 2/6/72 CONTRACT NO. AA823X-575

DRAWN BY: LES TOWNSEND COUNTY: ANNE ARUNDEL

DESIGNED BY: SIGNAL NO.: 02008

CHECKED BY: J SPENCE DRAWING NO. TS-448B